

PAT; outdoor
1300


NOTE:
THE AS-BUILT CONDITION IS DEPICTED FOR THE CONCORD CHILDREN'S CENTER SITE ONLY. THE INFORMATION PROVIDED FOR SURROUNDING AREAS SUCH AS MAIN AND CHURCH STREETS, HARVEY WHEELER, AND THE CHURCH BUILDING IS PART OF THE EXISTING CONDITIONS PLAN.

MY TAKE ON THE AREA:

$\square = 130 \times 55 = 7150$
 $\triangle = 1/2(40 \times 50) = 1000$
 $\triangle = 1/2(40 \times 45) = 900$

TOTAL = 5250 SF
 IF 'FLAT'
 ADD 15-20% (?) FOR
 SLOPE → 6,000 SF


- LEGEND
- CG •
 - WC +
 - 6" CLF
 - CB ■
 - 10" W
 - 24" D
 - 12" S
 - E
 - 6" O
 - T
 - OHW
 - x147.2
 - TO 152.1
 - BT 152.2
 - EOP
 - 14" D
 - DYSL
 - SWSL
 - FP
 - MB
 - FF
 - HP
 - 4" (F)
 - 2" (F)

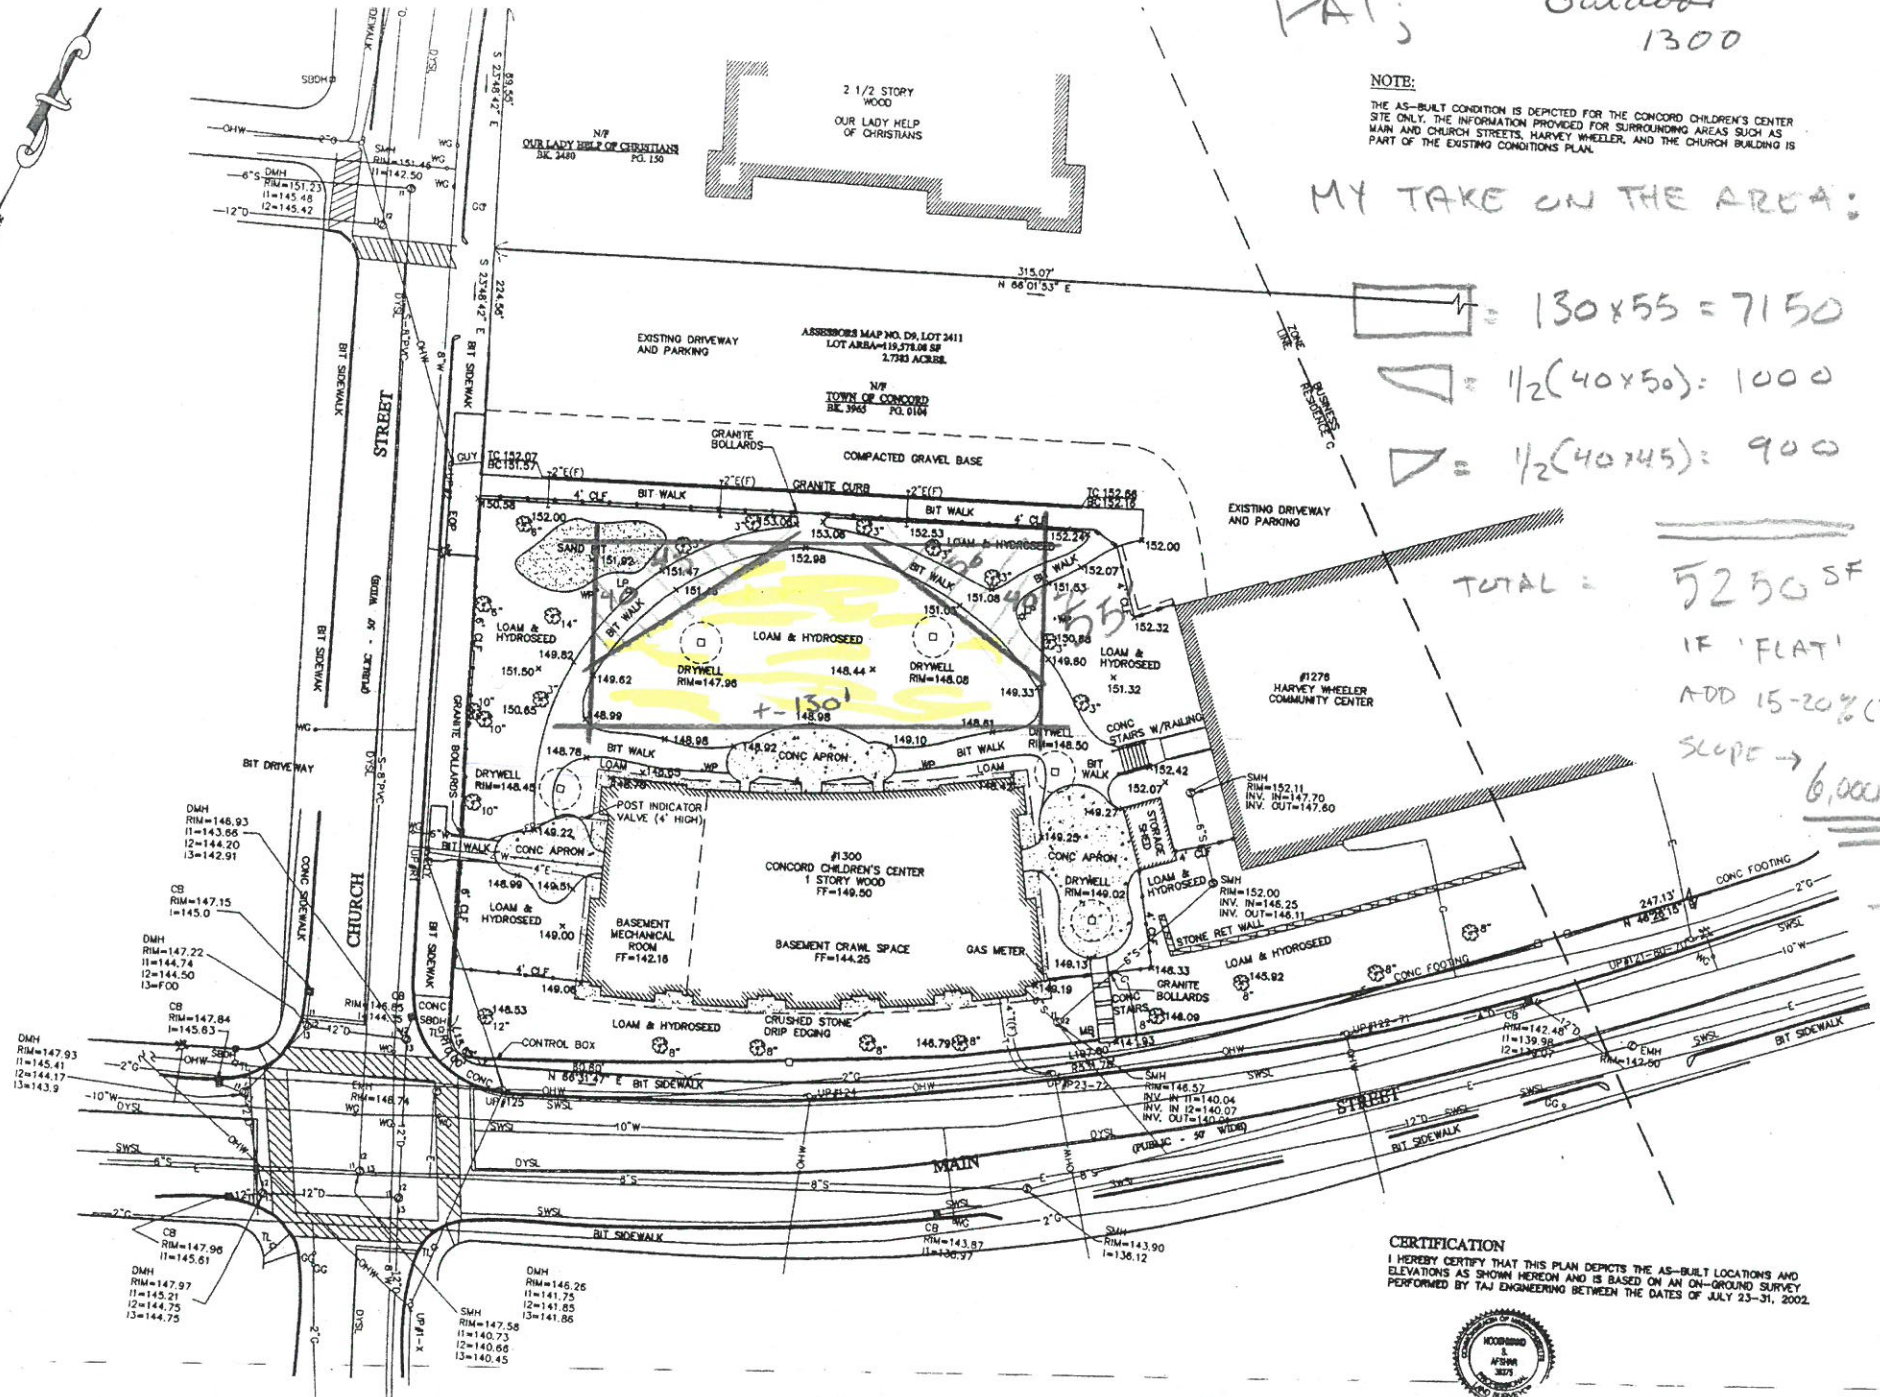

CERTIFICATION
I HEREBY CERTIFY THAT THIS PLAN DEPICTS THE AS-BUILT LOCATIONS AND ELEVATIONS AS SHOWN HEREON AND IS BASED ON AN ON-GROUND SURVEY PERFORMED BY TAJ ENGINEERING BETWEEN THE DATES OF JULY 23-31, 2002.



PROFESSIONAL LAND SURVEYOR

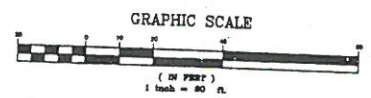

Fenced-in area excluding buildings = 18 039 sq ft

AS-B
CONCORD
13
WEST
THOUGH
543 MA
WI
TAJ
Engin
Coni
I Old
Cheli
Phot
SSA

8/2/2002
DATE