

REVISIONS	BY



FRONT ELEVATION AS-BUILT



RIGHT SIDE ELEVATION AS-BUILT



REAR ELEVATION AS-BUILT




LEFT SIDE ELEVATION AS-BUILT

Elise Braceras Stone, Architects
 288 Old Marlboro Road, Concord MA ebrstone@comcast.net
 (617) 306-6359

31700 LANG ST.
 CONCORD, MA.
 ELEVATIONS AS-BUILT

DRAWN
CHECKED
DATE 6/10/23
SCALE 1/4" = 1'-0"
JOB NO.
SHEET
OF SHEETS

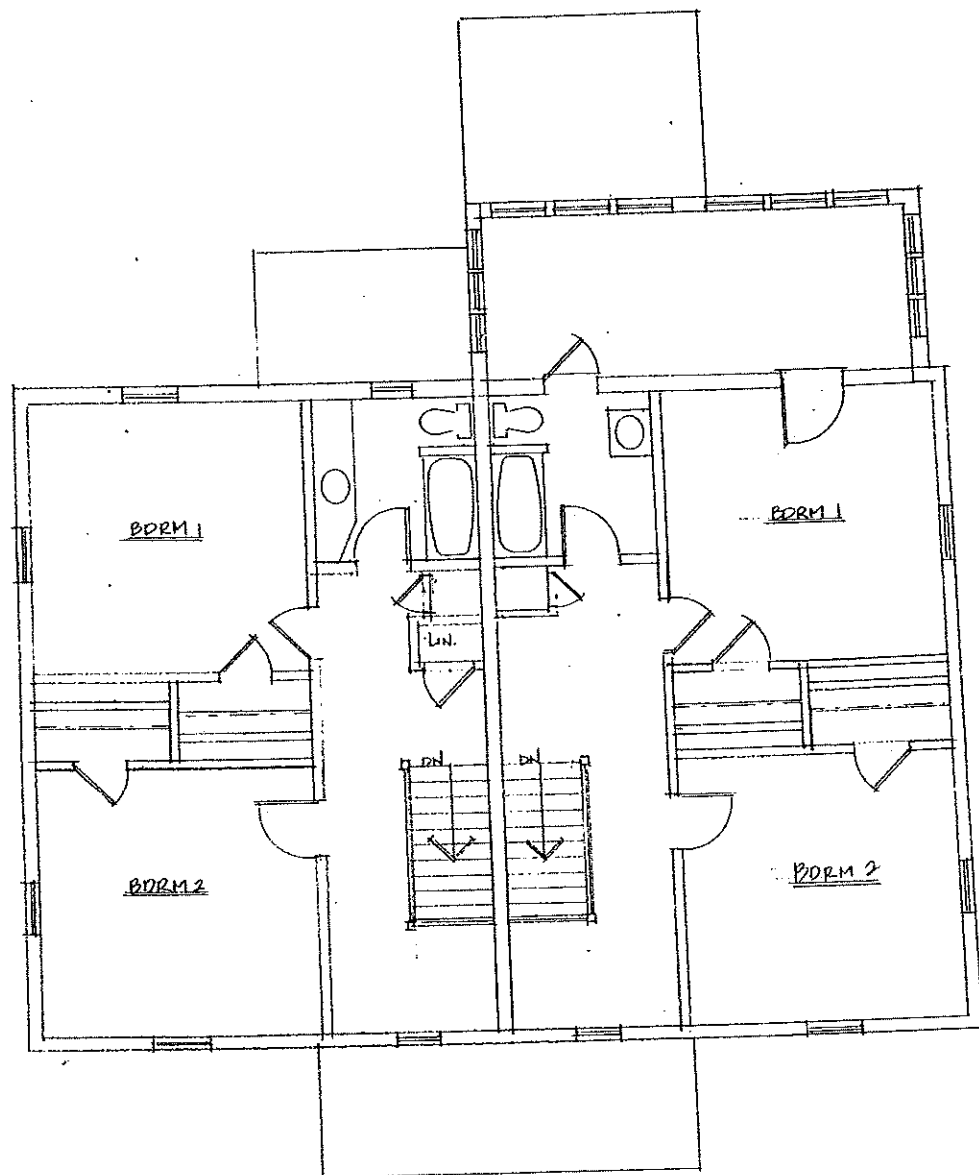


SECOND FLOOR PLAN AS-BUILT 1499 SF. TOTAL

REVISIONS	BY

Elise Braceras Stone, Architects
 288 Old Marlboro Road, Concord MA 03301
 (617) 306-6339
 elstone@comcast.net

21 FOS LANG ST.
 CONCORD, MA
 SECOND FLOOR PLAN AS-BUILT

DRAWN
CHECKED
DATE 6/10/23
SCALE 1/8" = 1'-0"
JOB NO.
SHEET
OF SHEETS

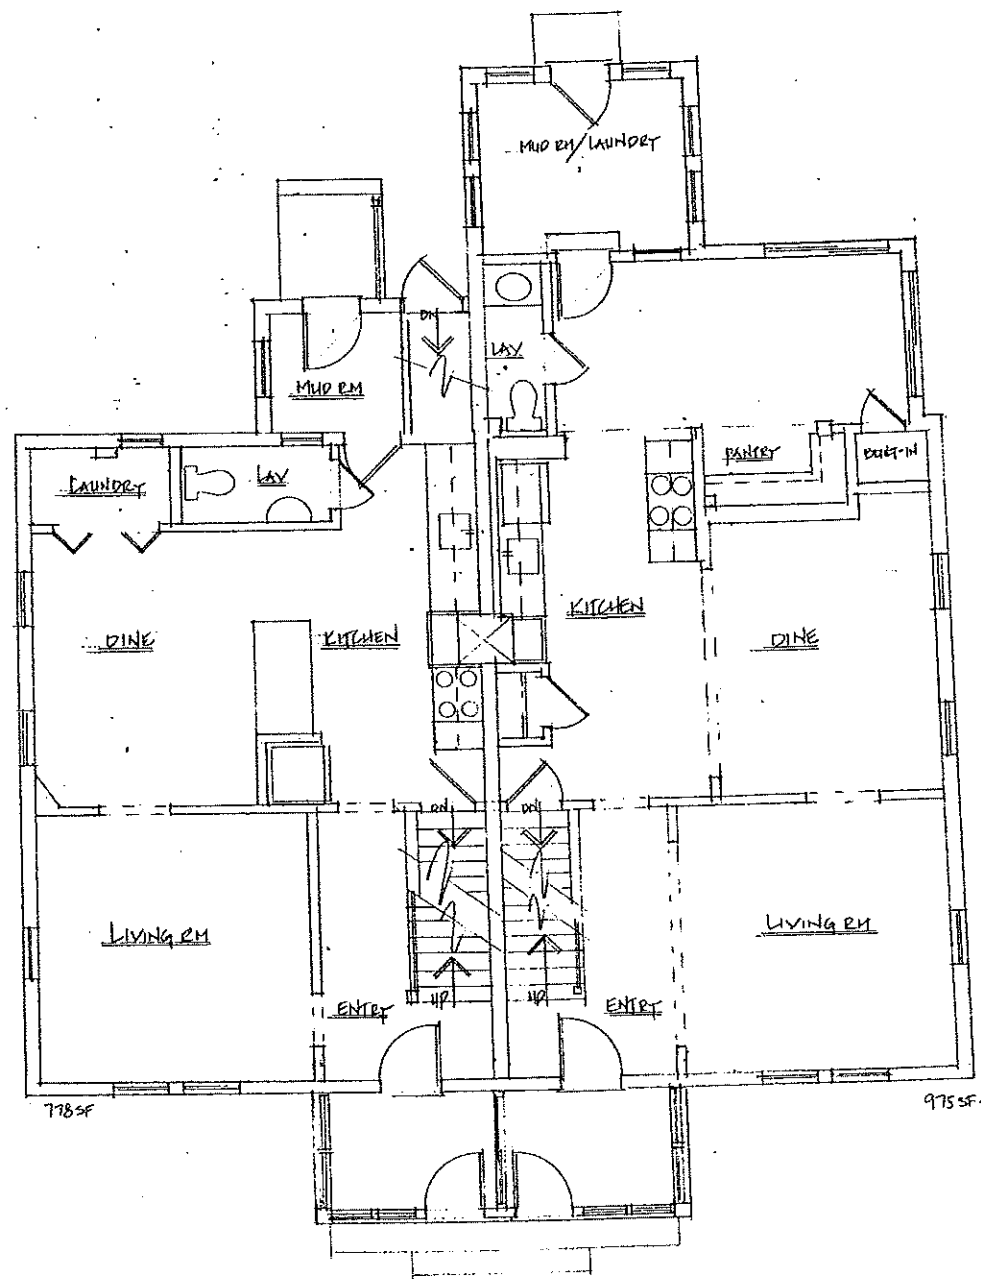

778 SF

975 SF

FIRST FLOOR PLANS AS BUILT

TOTAL - 1753 SF FIRST FL
 HOUSE TOTAL - 3253 SF

REVISIONS	BY

Elise Braceras Stone Architects
 288 Old Marlboro Road, Concord MA elstone@comcast.net
 (617) 306-6359

31 + 220 LANG ST.
 CONCORD, MA
 FIRST FLOOR PLAN AS BUILT


DRAWN
CHECKED
DATE 6/10/23
SCALE 1/4" = 1'-0"
JOB NO.
SHEET
OF SHEETS

REVISIONS	BY

Elise Braceras Stone, Architects
 288 Old Marlboro Road, Concord MA
 elstone@comcast.net
 (617) 306-6359

31 & 32 LANG ST
 CONCORD MA
 ELEVATIONS

DRAWN
 CHECKED
 DATE 6/10/23
 SCALE 1/4" = 1'-0"
 JOB NO.
 SHEET
 A.4
 OF SHEETS

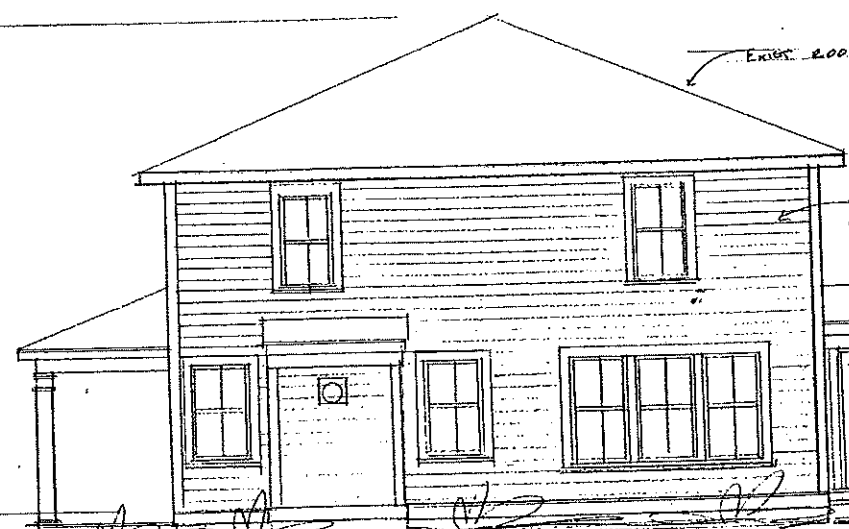

RIGHT SIDE ELEVATION - EXIST HOUSE



FRONT ELEVATION - NEW HOUSE



REAR ELEVATION - NEW HOUSE



REAR ELEVATION - EXIST HOUSE

REVISIONS	BY


Elise Braceras Stone, Architects
 288 Old Marlboro Road, Concord MA abstone@concast.net
 (617) 306-6359

31 & 32 LANG ST
 CONCORD MA
 ELEVATIONS


DRAWN
CHECKED
DATE 6/10/23
SCALE 1/4" = 1'-0"
JOB NO.
SHEET A3
OF SHEETS



FRONT ELEVATION - EXISTING HOUSE

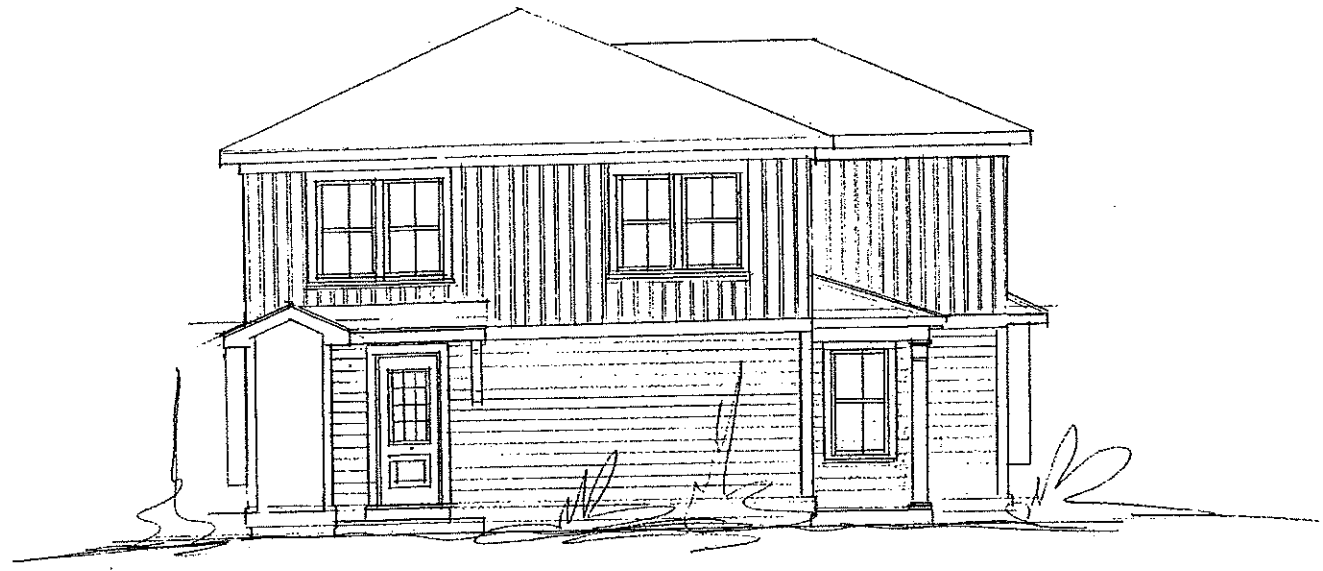

LEFT SIDE ELEVATION - NEW HOUSE

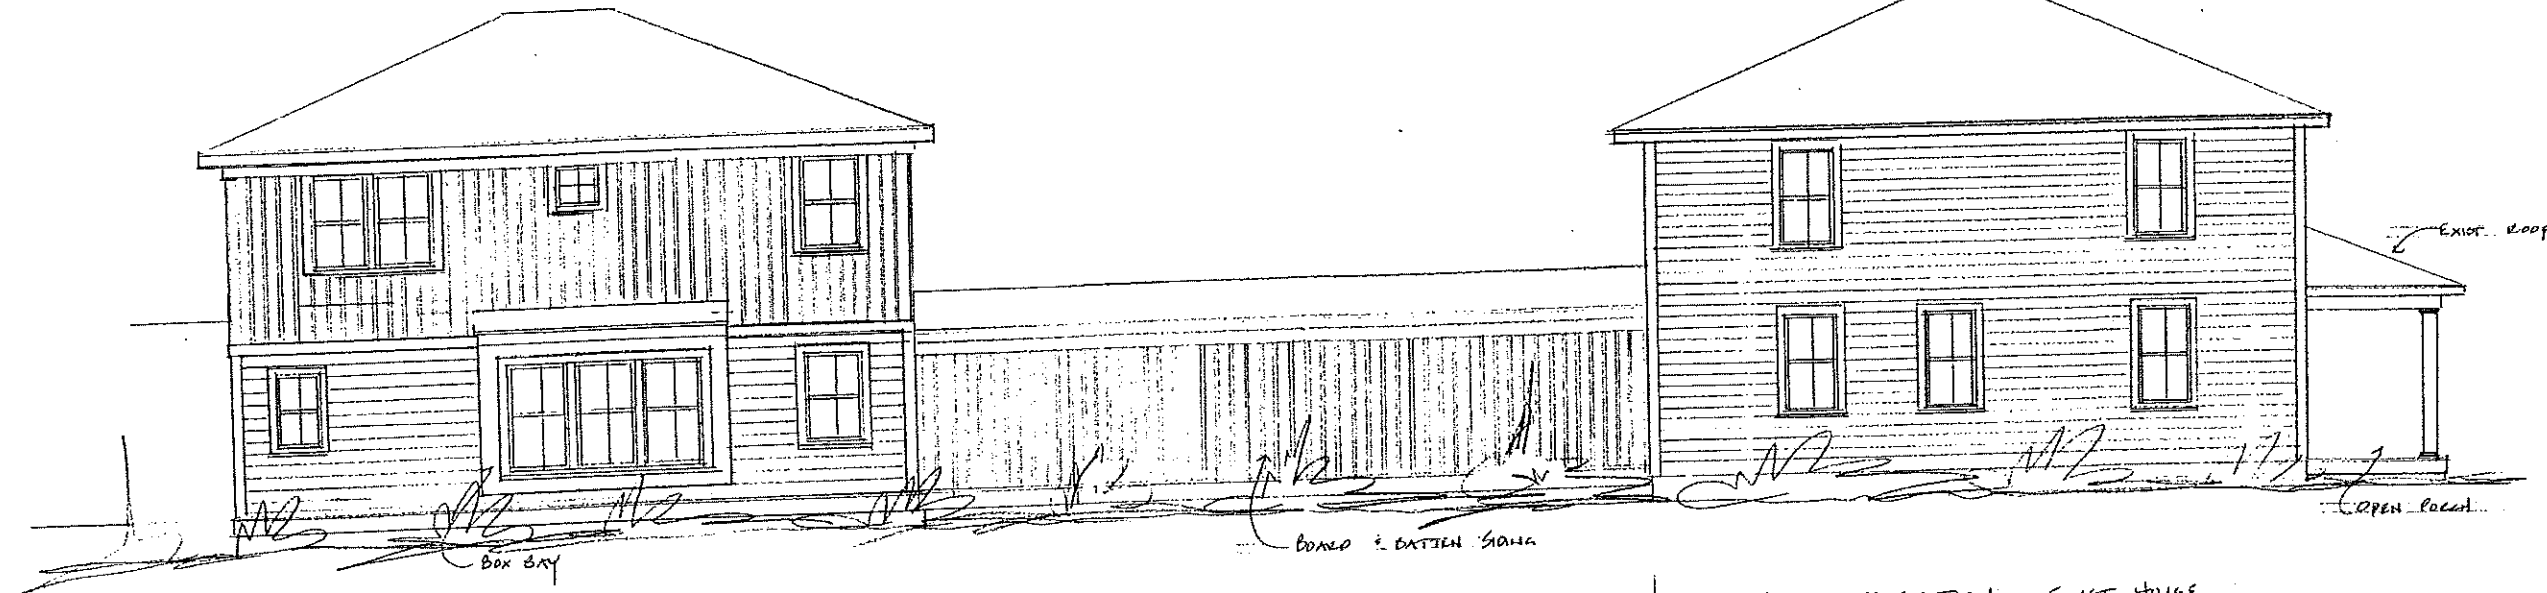

REAR ELEVATION - NEW HOUSE

LEFT SIDE ELEVATION - EXIST HOUSE


REVISIONS	BY

Elise Braceras Stone, Architects
 288 Old Marlboro Road, Concord MA elstone@comcast.net
 (617) 306-6339

31 & 32 LANG ST
 CONCORD MA
 FIRST FLOOR PLAN

DRAWN
CHECKED
DATE 6/10/23
SCALE 1/4" = 1'-0"
JOB NO.
SHEET A-1
OF SHEETS

NOTE:
 REFLECT AND EXIST WINDOWS
 BY SAME FIRM - SAME STYLE
 NEW WINDOWS

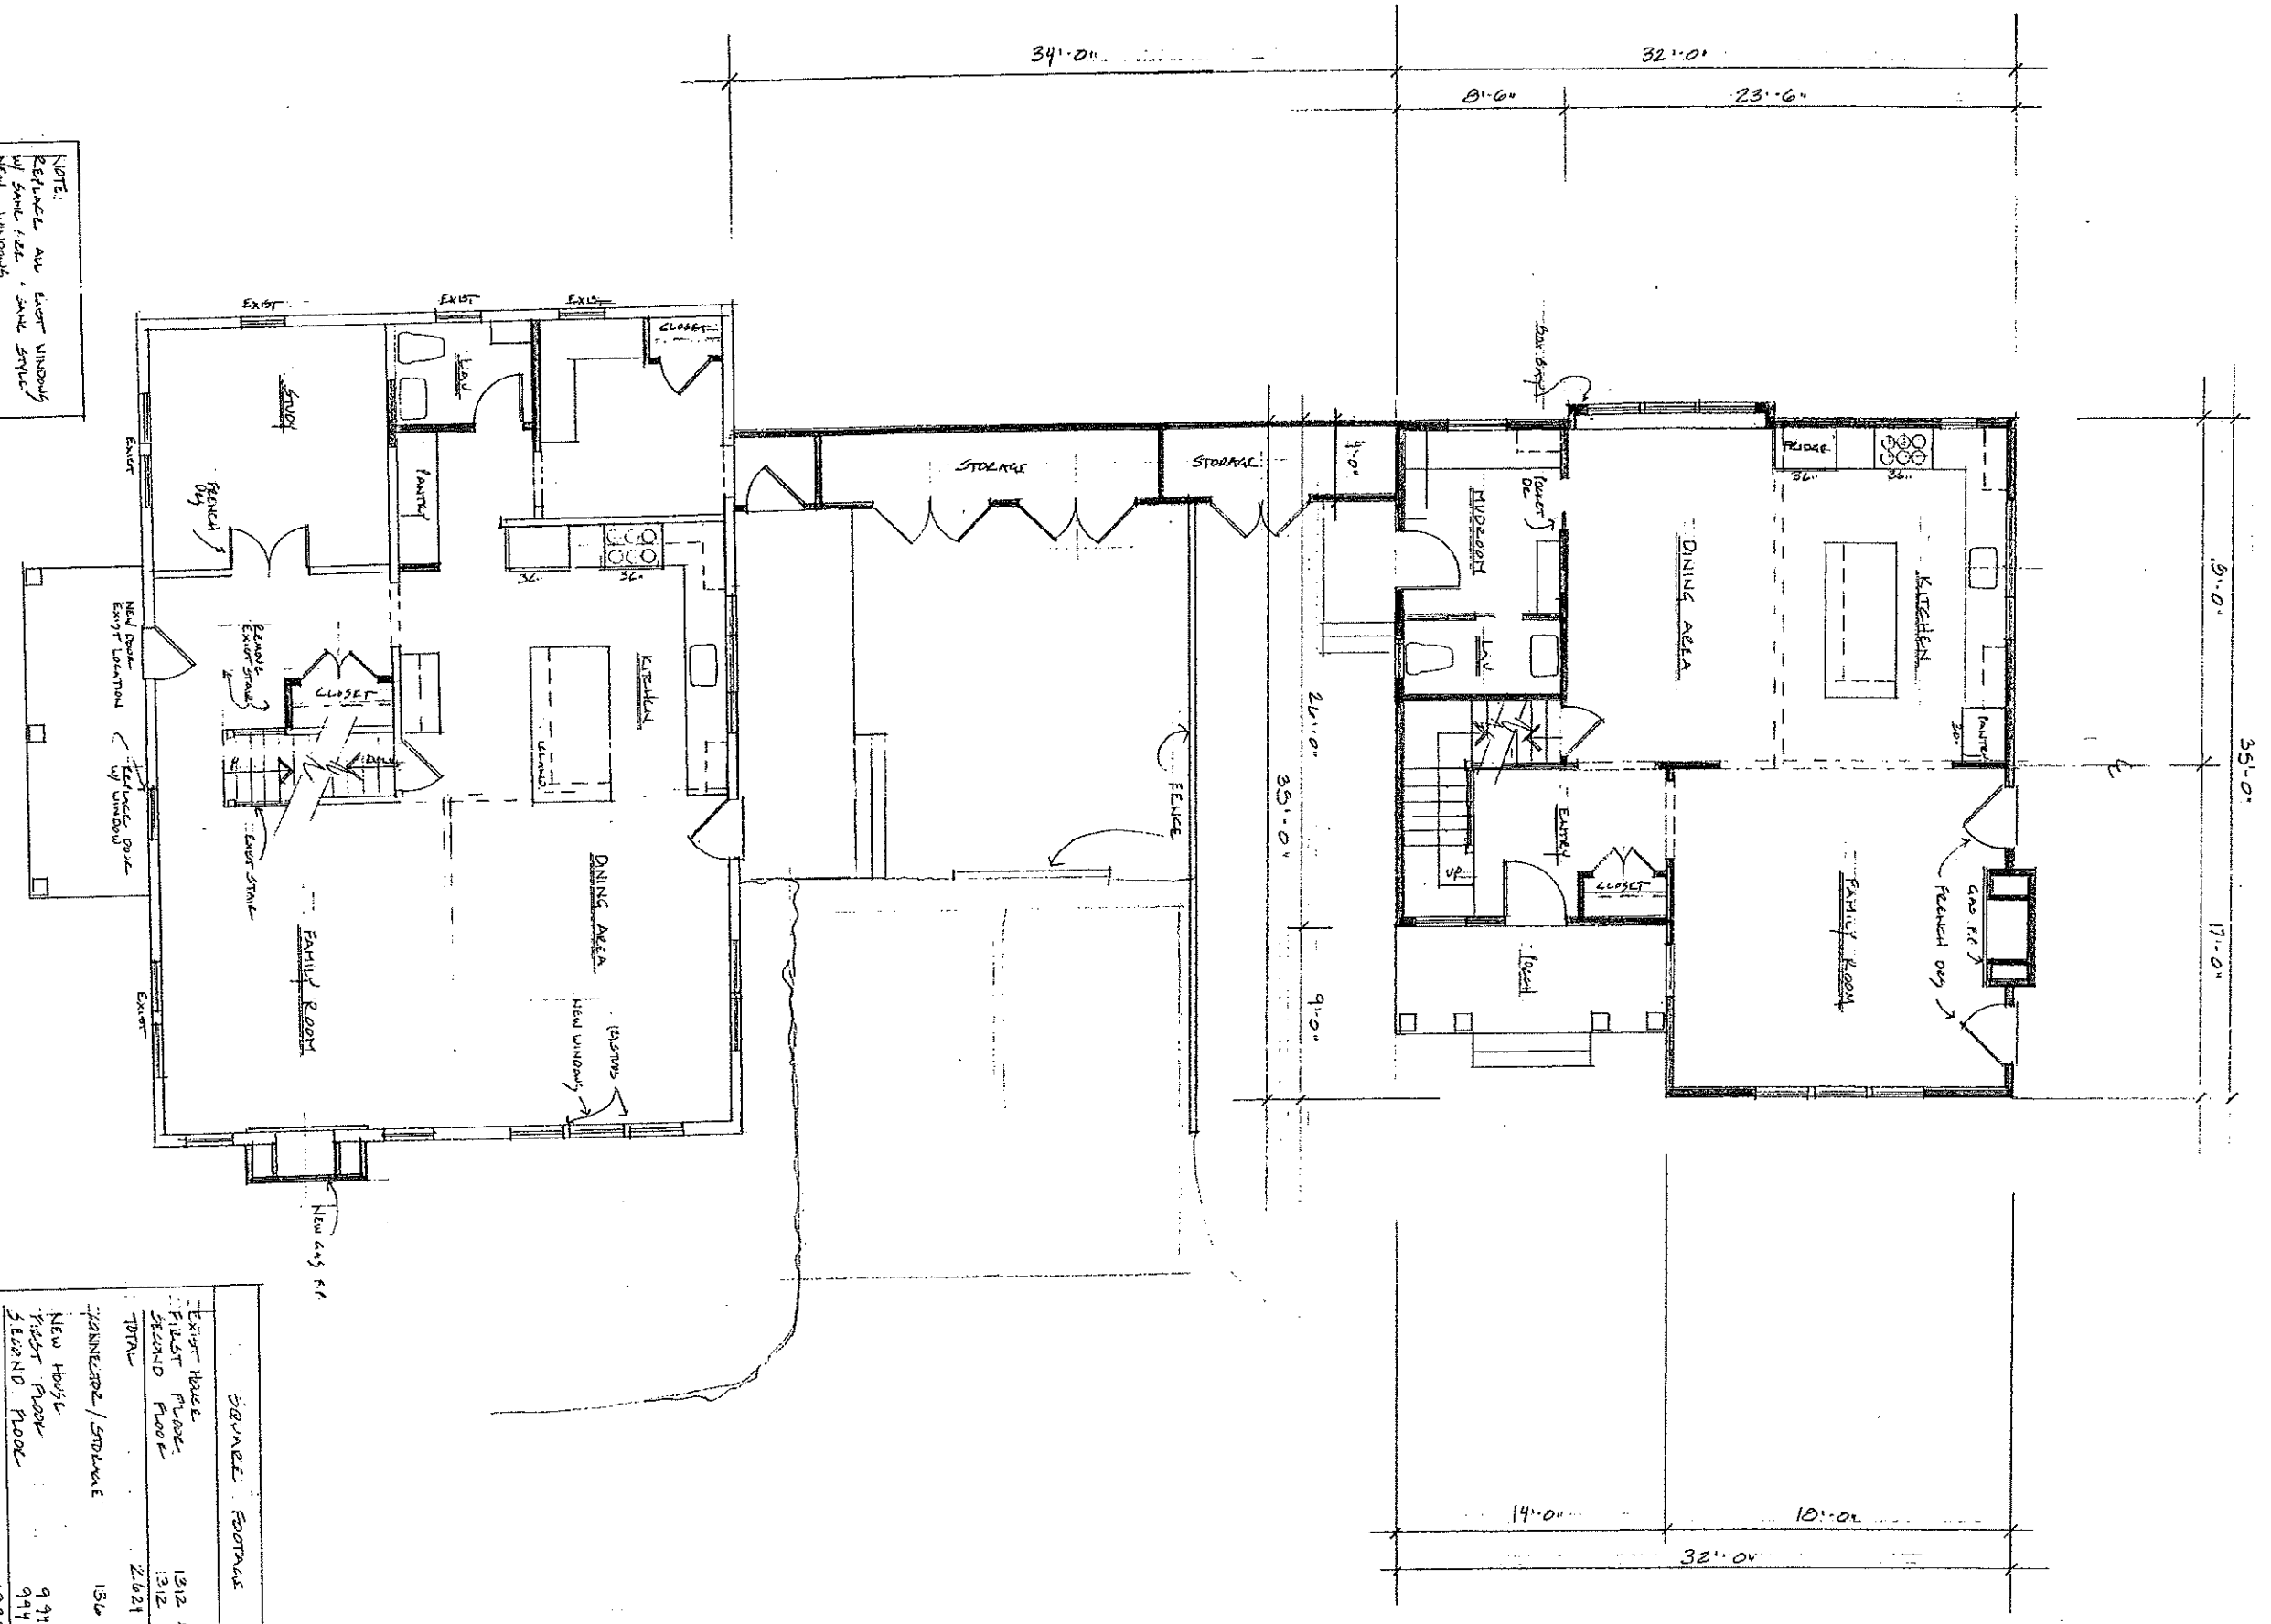

SQUARE FOOTAGE	
EXIST HOUSE	1812 sq
FIRST FLOOR	312 sq
SECOND FLOOR	2021 sq
TOTAL	1345 sq
NEW HOUSE	991 sq
FIRST FLOOR	941 sq
SECOND FLOOR	1989 sq
TOTAL	4773 sq
TOTAL OF BOTH	7922 sq
MAX FAVE	7922 sq