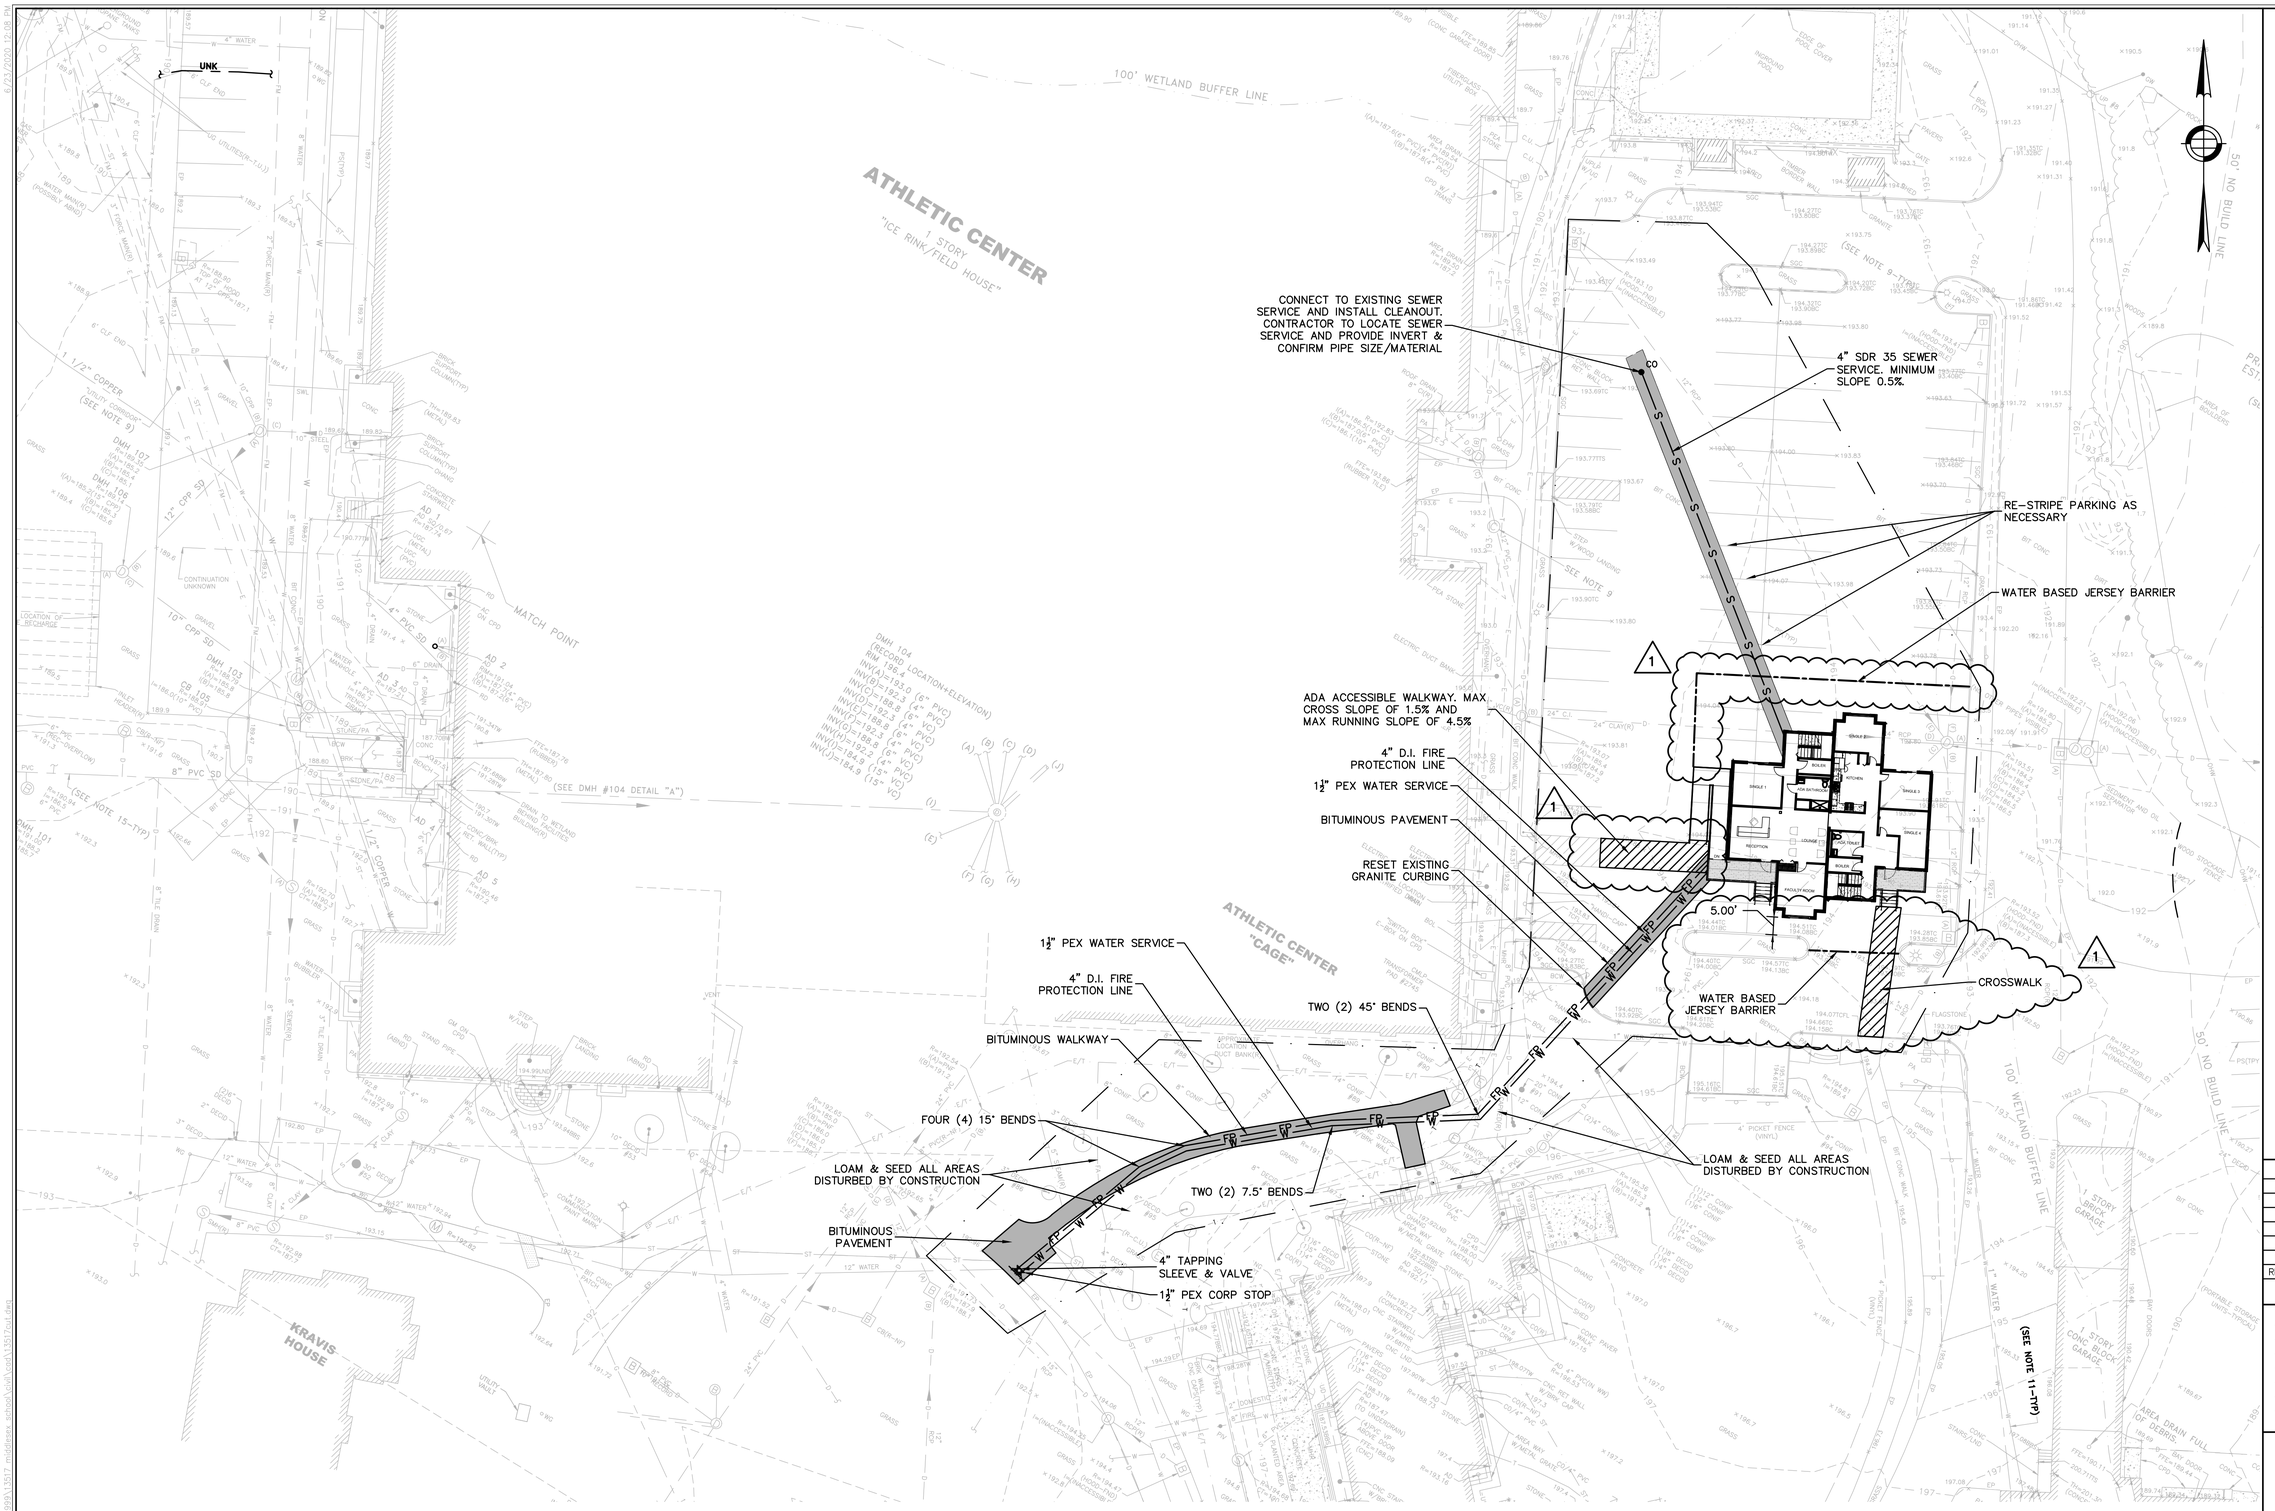

Nitsch Engineering
www.nitscheng.com
2 Center Plaza, Suite 430
Boston, MA 02108
T: (617) 338-0063
F: (617) 338-6472

- Civil Engineering
- Land Surveying
- Transportation Engineering
- Structural Engineering
- Green Infrastructure
- Planning
- GIS

SITE LAYOUT & UTILITIES

MIDDLESEX SCHOOL TRANSITIONAL HOUSING
1400 LOWELL ROAD, CONCORD, MA 01742

PREPARED FOR:
MIDDLESEX SCHOOL
1400 LOWELL ROAD, CONCORD, MA 01742

COMMONWEALTH OF MASSACHUSETTS
STEVEN VENTRESCA
CIVIL
No. 46872
REGISTERED PROFESSIONAL ENGINEER

REV.	COMMENTS	DATE
	REVISIONS	
1	TOWN MARKUPS	6/23/20

NITSCH PROJECT #	13517
FILE:	13517CDM
SCALE:	1"=20'
DATE:	06/18/2020
PROJECT MANAGER:	SV
SURVEYOR:	
DRAFTED BY:	BB
CHECKED BY:	SV

SHEET:

C200

OF REV.